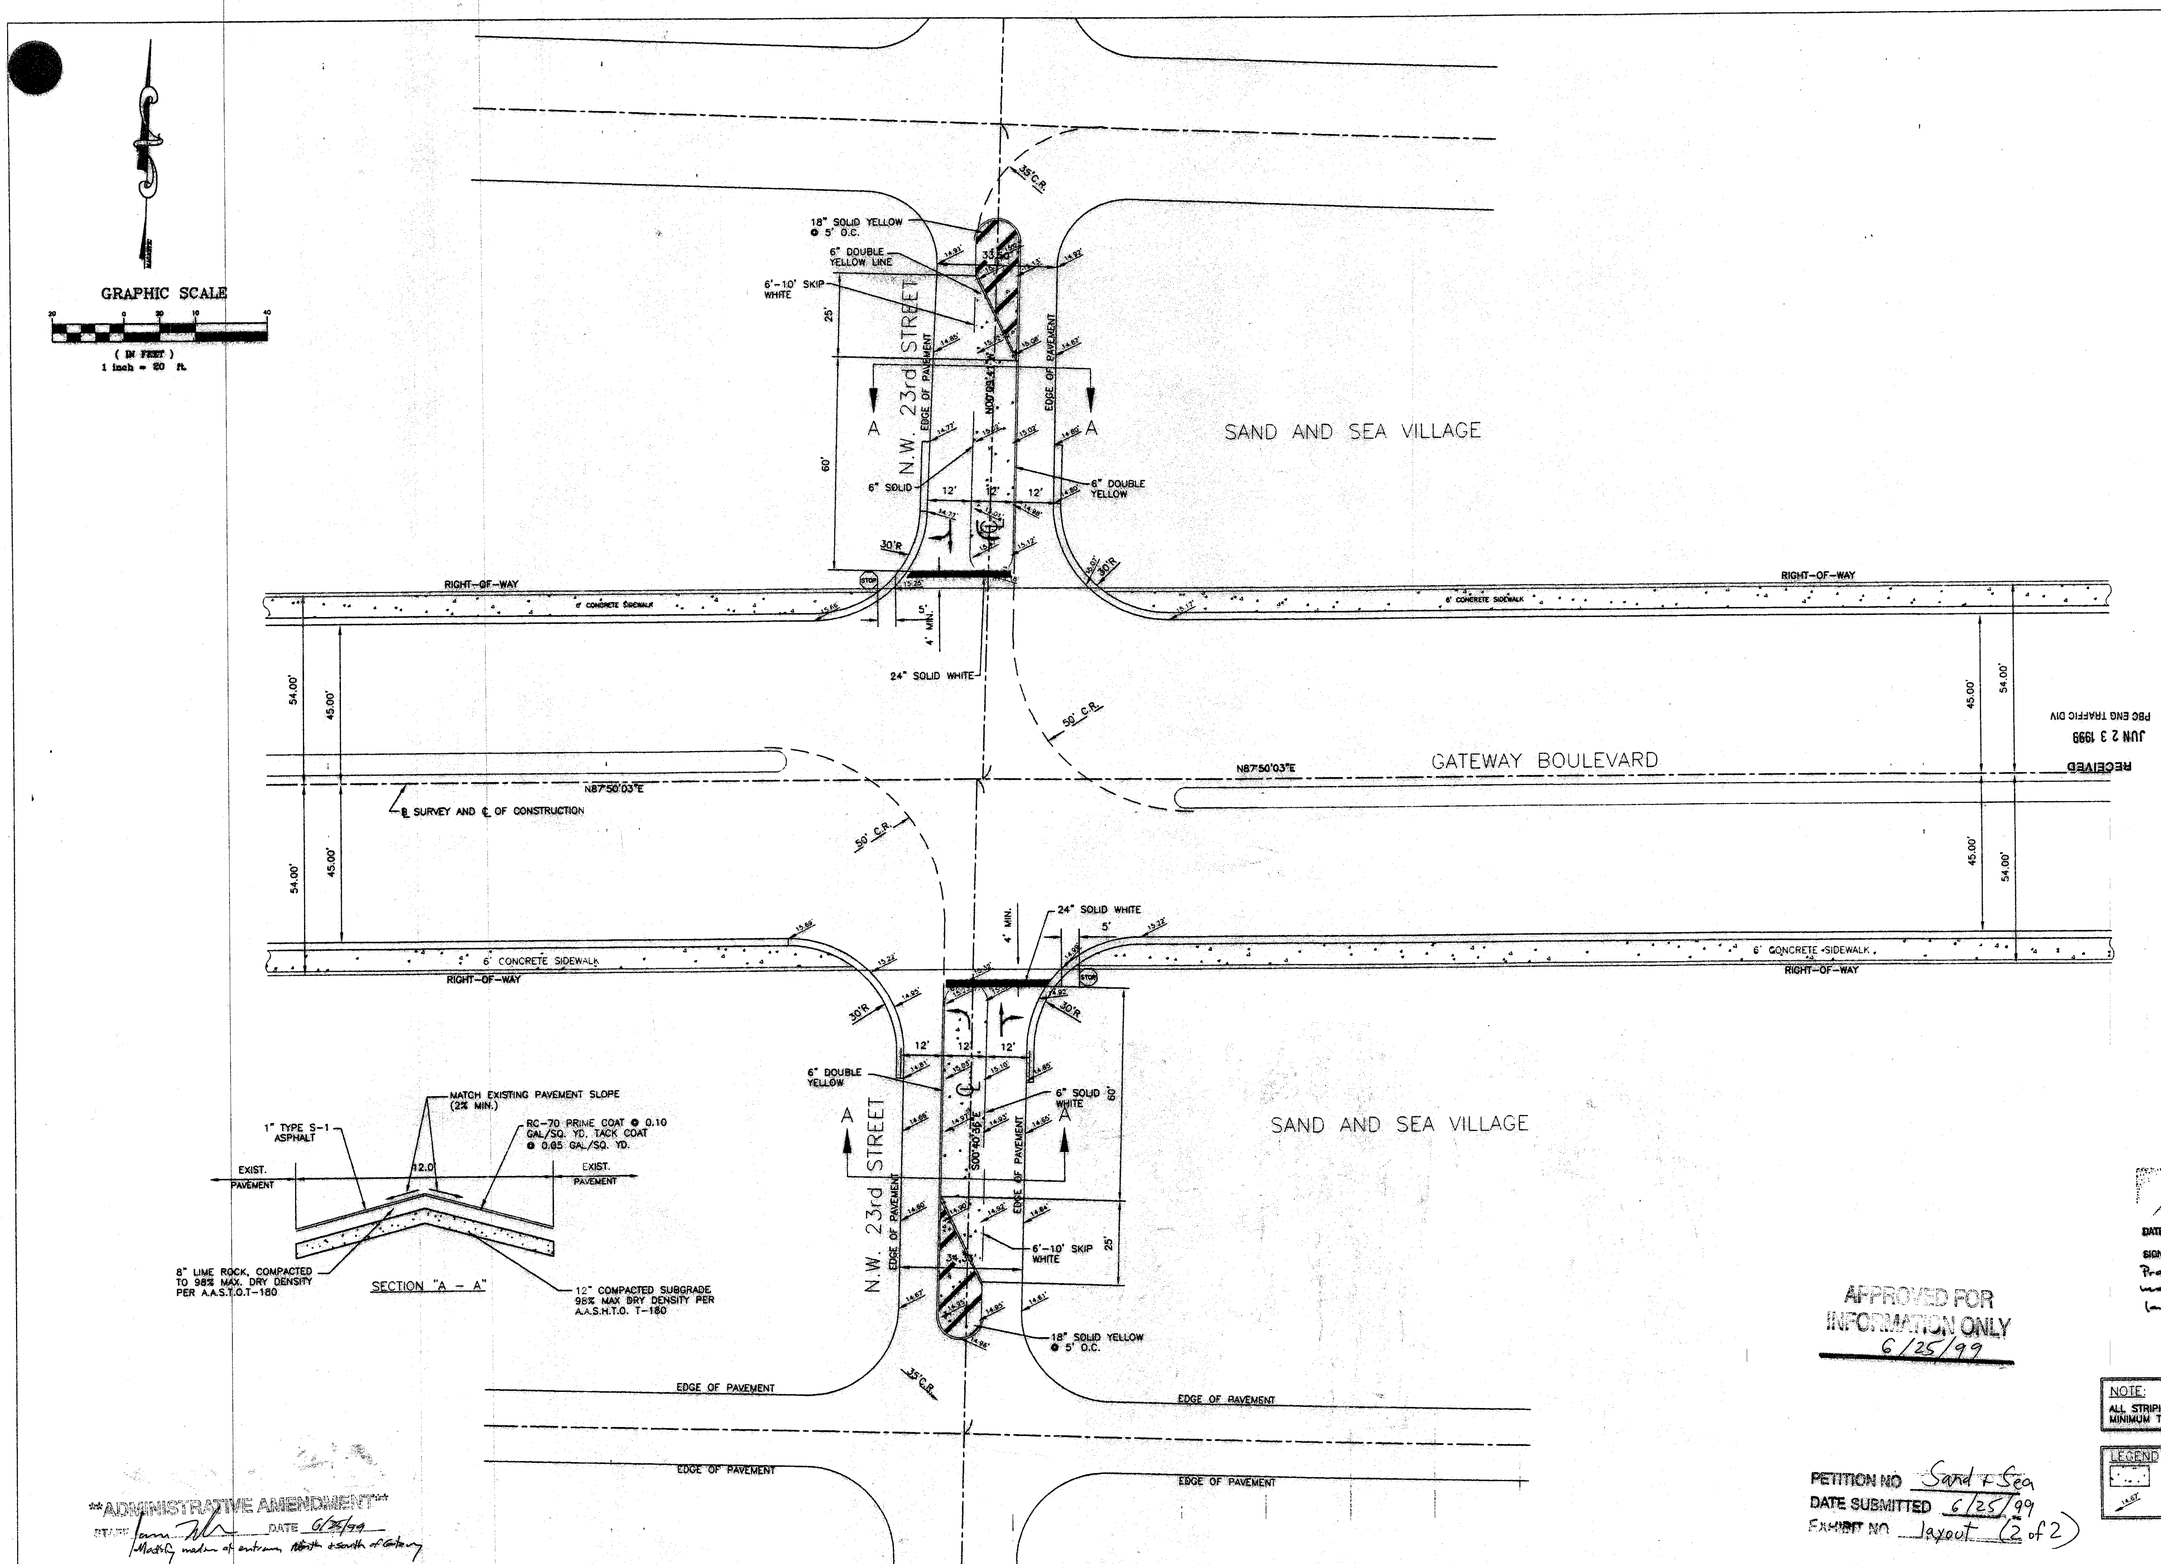

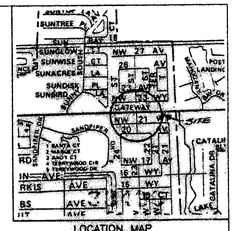

APPROVED AS NOTED
PALM BEACH COUNTY
TRAFFIC DIVISION
DATE: 6-24-99
SIGNATURE:
Proposal to pave existing entrance medians for use as left turn lanes.

APPROVED FOR INFORMATION ONLY
6/25/99

NOTE:
ALL STRIPING SHALL BE THERMOPLASTIC PER F.D.O.T. SPECIFICATIONS MINIMUM THICKNESS 90 MILS.

LEGEND
EXISTING MEDIAN PLANTER AREA (CURBS REMOVED)
EXISTING ELEVATION

PETITION NO Sand + Sea
DATE SUBMITTED 6/25/99
EXHIBIT NO layout (2 of 2)

ADMINISTRATIVE AMENDMENT
STAFF [signature] DATE 6/25/99
Modify median of entrance North & South of Gateway

CARNEY-NEUHAUS, INC. LB5770
11811 U.S. HIGHWAY 1, SUITE 120 PALM BEACH GARDENS, FL 33408 TEL: (561)622-1300 FAX: (561)622-1428
3050 BISCAYNE BLVD. SUITE 200 MIAMI, FL 33139 TEL: (305)576-9990 FAX: (305)576-9900
4101 N. ANDREWS AVE., SUITE 213 FORT LAUDERDALE, FL 33309 TEL: (954)565-0530 FAX: (954)565-3924

THIS DRAWING NOT VALID UNLESS SEALED WITH EMBOSSED SEAL.

DATE:	4-30-99				
DWG BY:	JLG				
CHKED BY:	D.O.C.	6/18/99	JLG.	D.O.C.	REVISED PER TRAFFIC DEPT. REVIEW
P.B.:		DATE	BY	SIGNED	REVISION

PROPOSED ACCESS ROAD IMPROVEMENTS
SAND AND SEA VILLAGE MOBILE HOME COMMUNITY
PALM BEACH COUNTY FLORIDA

SCALE:	1" = 20'
PROJECT No.	85 -311B
SHEET No.	1 of 1
FILE No.	85 - 311B